
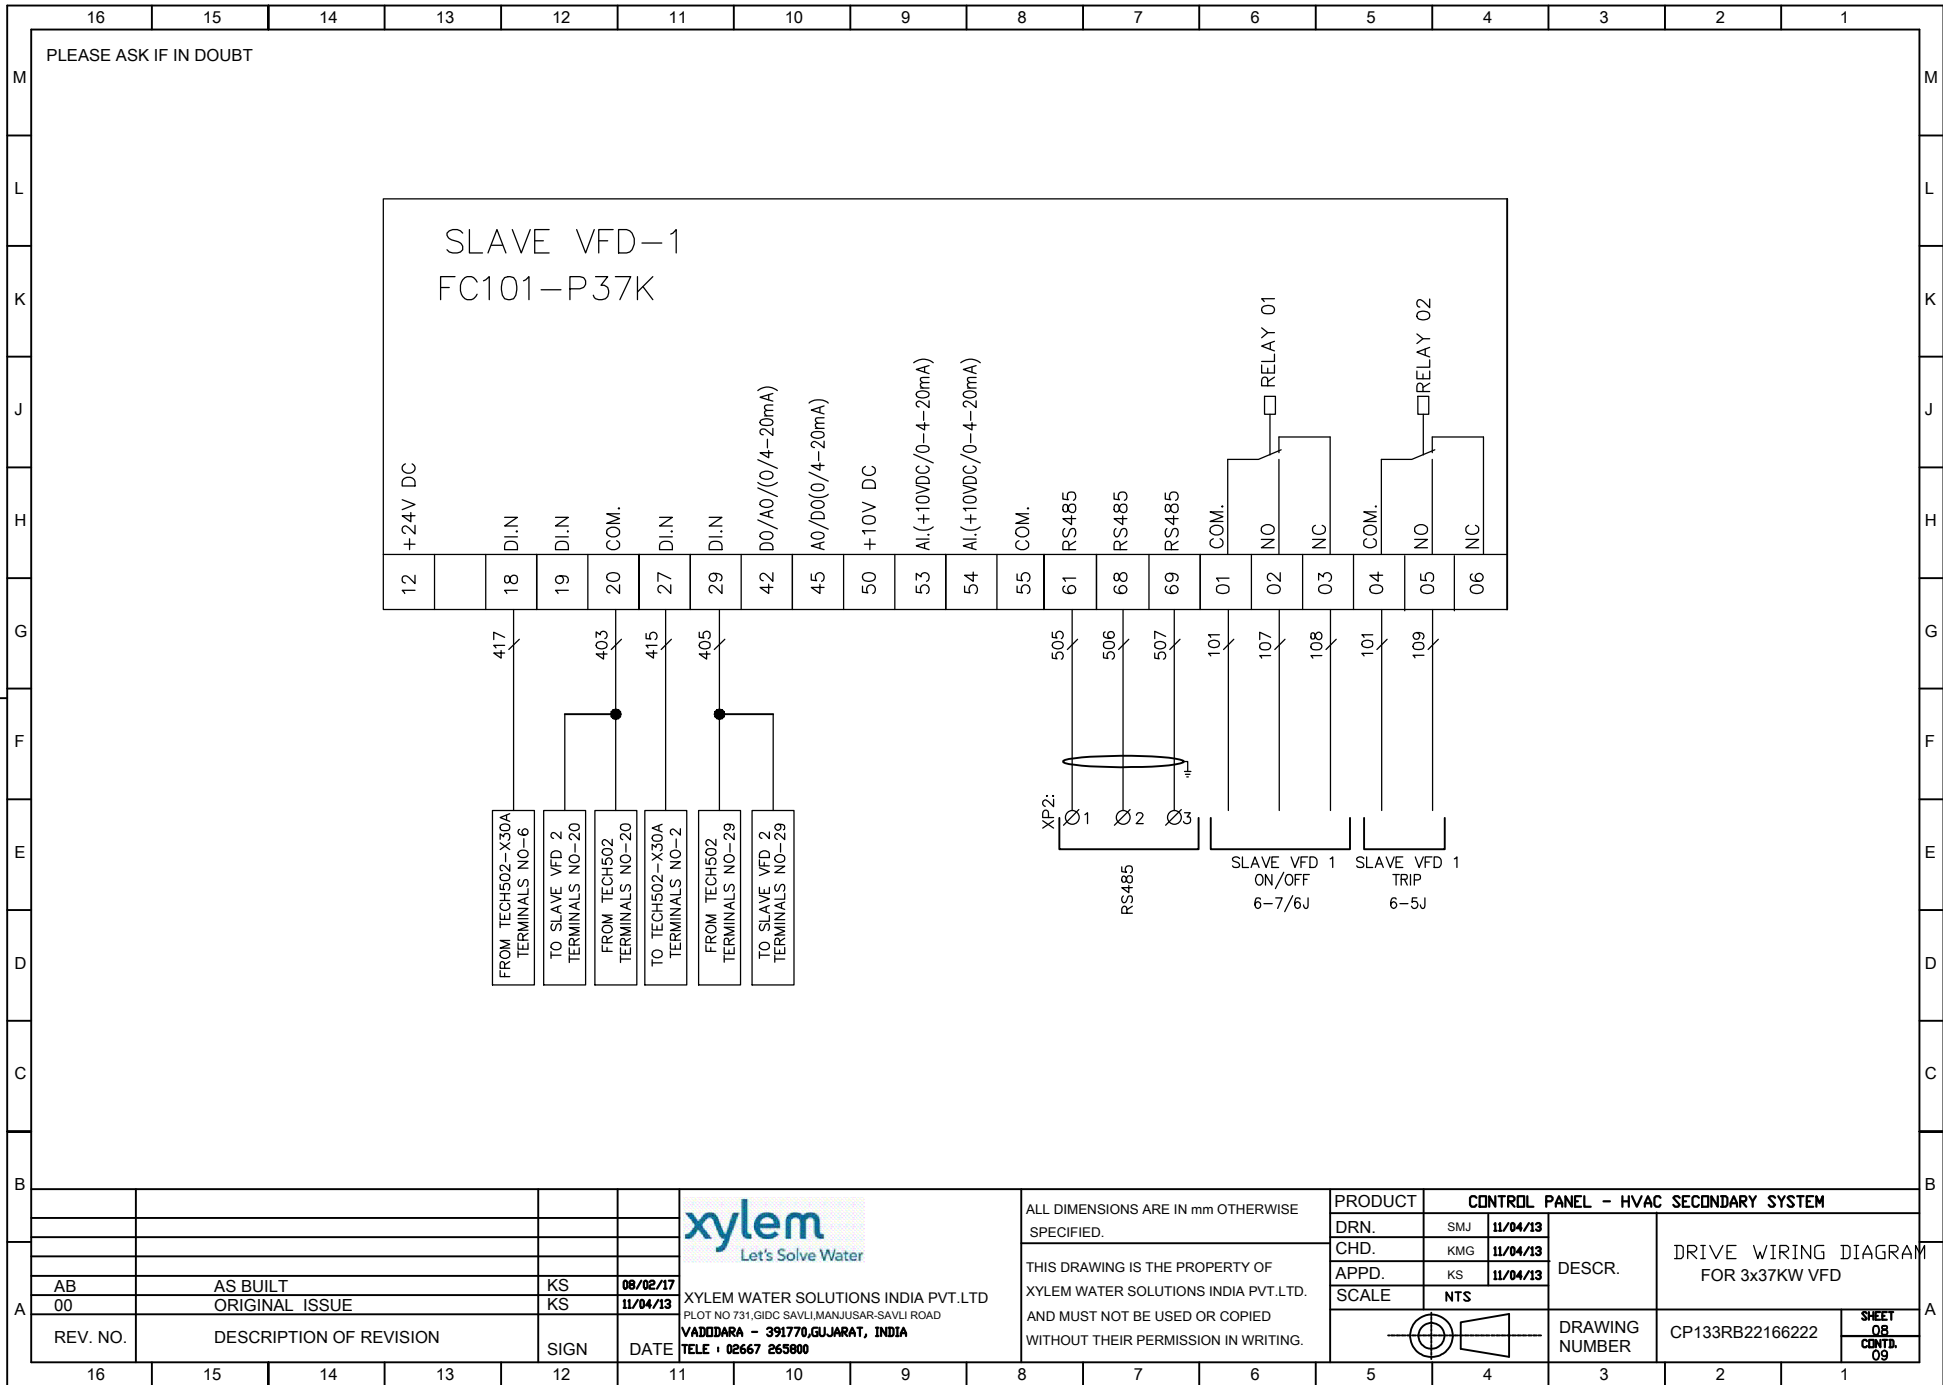




ALL DIMENSIONS ARE IN mm OTHERWISE SPECIFIED.

THIS DRAWING IS THE PROPERTY OF XYLEM WATER SOLUTIONS INDIA PVT.LTD. AND MUST NOT BE USED OR COPIED WITHOUT THEIR PERMISSION IN WRITING.

PRODUCT		CONTROL PANEL - HVAC SECONDARY SYSTEM					
DRN.	SMJ	11/04/13	DESCR.	DRIVE WIRING DIAGRAM FOR 3x37KW VFD			SHEET 07 CONTD. 08
CHD.	KMG	11/04/13					
APPD.	KS	11/04/13					
SCALE	NTS						
			DRAWING NUMBER	CP133RB22166222			



				 Let's Solve Water	ALL DIMENSIONS ARE IN mm OTHERWISE SPECIFIED.	PRODUCT CONTROL PANEL - HVAC SECONDARY SYSTEM						
						DRN.	SMJ	11/04/13	DESCR.	DRIVE WIRING DIAGRAM FOR 3x37KW VFD		
					CHD.	KMG	11/04/13					
					APPD.	KS	11/04/13					
A	AB	AS BUILT	KS	08/02/17	XYLEM WATER SOLUTIONS INDIA PVT.LTD PLOT NO 731,GIDC SAVLI,MANJUSAR-SAVLI ROAD VADODARA - 391770,GUJARAT, INDIA TELE : 02667 265800	THIS DRAWING IS THE PROPERTY OF XYLEM WATER SOLUTIONS INDIA PVT.LTD. AND MUST NOT BE USED OR COPIED WITHOUT THEIR PERMISSION IN WRITING.	SCALE	NTS		DRAWING NUMBER	CP133RB22166222	SHEET 08 OF 09
	00	ORIGINAL ISSUE	KS	11/04/13								
	REV. NO.	DESCRIPTION OF REVISION	SIGN	DATE								

